REMARKS

Applicants respectfully request that the foregoing amendments be entered before examination of the above-captioned application. FIG. 3 has been removed from the drawings. The additional amendments are made in view of the removal of FIG. 3. The Examiner is respectfully requested to approve the proposed drawings changes and replacement figures.

CONCLUSION

On the basis of the above, early allowance of the application is believed to be warranted and such action is respectfully requested. If the Examiner has any questions or comments regarding this amendment, a telephone call to the undersigned at the number listed below is respectfully urged.

Respectfully submitted,


Dated: ______


Bv:


Stephen C. Beuerle Reg. No. 38,380


Procopio, Cory, Hargreaves & Savitch LLP 530 B Street, Suite 2100 San Diego, California 92101-4469 (619) 238 1900



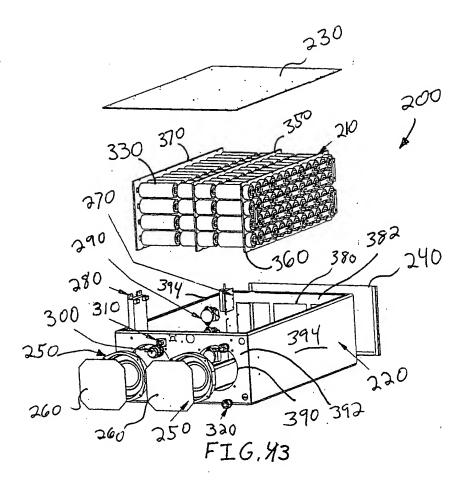


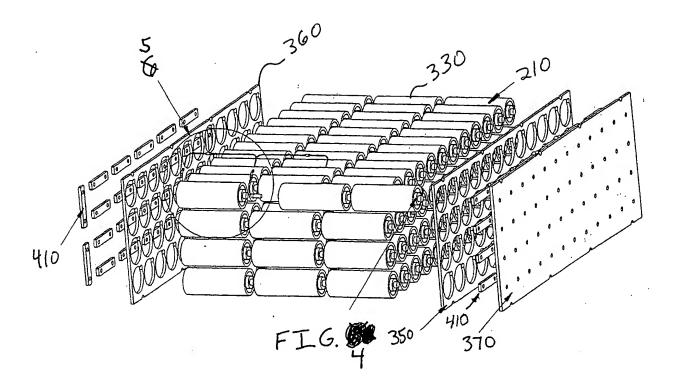

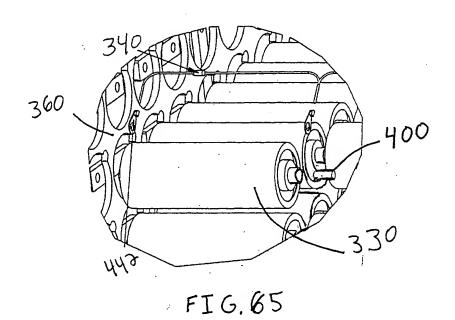

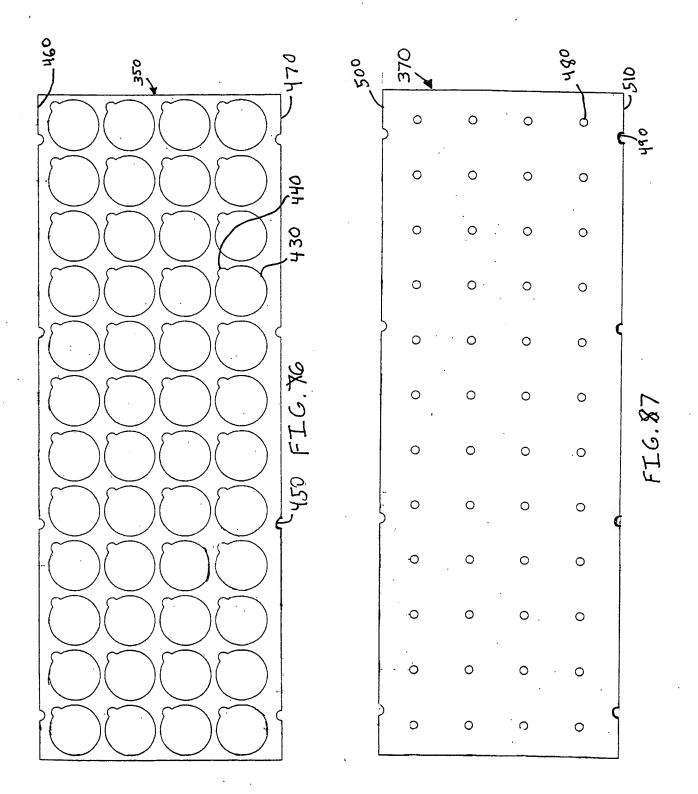

Redlined Drawings
Application No. 10/720,916 GAU 2836
Docket ISE13

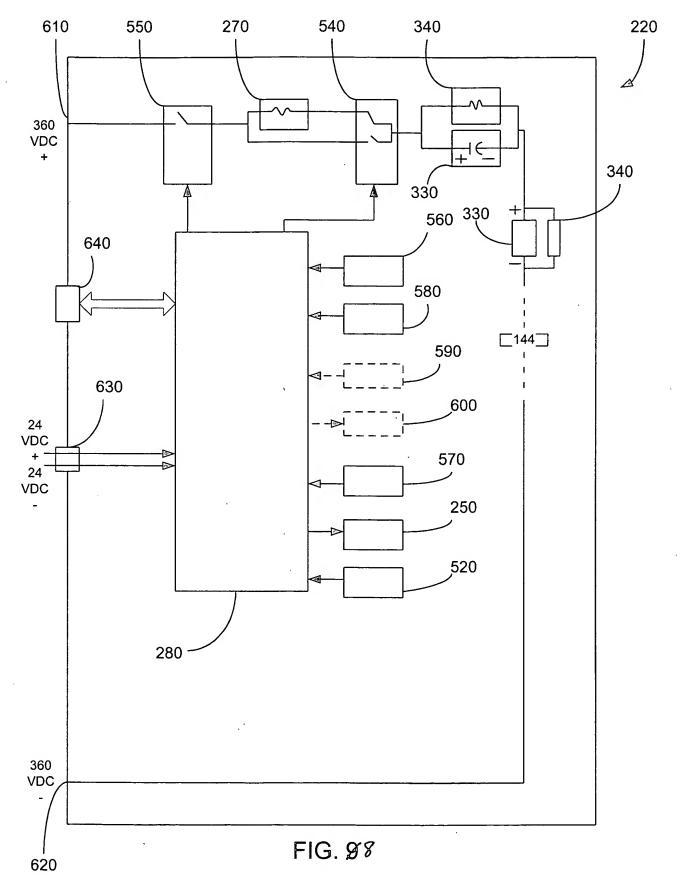

Redlined Drawings
Application No. 10/720,916 GAU 2836
Docket ISE13